

JOINT
PUBLIC NOTICE

CHARLESTON DISTRICT, CORPS OF ENGINEERS

69A Hagood Avenue

Charleston, South Carolina 29403-5107

and

THE S.C. DEPARTMENT OF HEALTH AND ENVIRONMENTAL CONTROL

Office of Environmental Quality Control

Water Quality Certification and Wetlands Programs Section

2600 Bull Street

Columbia, South Carolina 29201

REGULATORY DIVISION

7 February 2003

Refer to: P/N #2002-1L-298-C

Pursuant to Section 10 of the Rivers and Harbors Act of 1899 (~~33 U.S.C. 403~~), the ~~South Carolina Coastal Zone~~ Management Act (48-39-10 ~~et seq.~~) and the S.C. Construction in Navigable Waters Permit Program (R. 19-450, ~~et seq.~~, 1976 S.C. Code of Laws, as amended), an application has been submitted to the Department of the Army and the S.C. Department of Health and Environmental Control by

ROBERT P. HUCKS

5900 REBA ROAD

CONWAY, SOUTH CAROLINA 29527

for a permit to construct a walkway and floating dock and an after-the-fact approval for an existing deck in the

WACCAMAW RIVER

at 3647 Pitch Landing Drive, Conway, Horry County, South Carolina.
(Latitude – 33.79586, Longitude – 79.05425)

In order to give all interested parties an opportunity to express their views

NOTICE

is hereby given that written statements regarding the proposed and existing work will be received by both of the above mentioned offices until

12 O'CLOCK NOON, MONDAY, 28 FEBRUARY 2003

from those interested in the activity and whose interests may be affected by the proposed and existing work.

The proposed work consists of constructing a 5' x 25' fixed walkway leading from a 14' x 30' existing deck. A 4' wide ramp will lead from the proposed walkway to a proposed 10' x 20' floating dock. The existing bulkhead, shown on the attached plans, is authorized by a nationwide permit and, as such, no further processing is required by this office. This portion of the work, however, is subject to the permitting authority of the South Carolina Department of Health and Environmental Control. The purpose of this work is for the applicant's private recreational use.

REGULATORY DIVISION
Refer to: P/N #2002-1L-298-C
Robert P. Hucks

7 February 2003

NOTE: Plans depicting the work described in this notice are available and will be provided, upon receipt of a written request, to anyone that is interested in obtaining a copy of the plans for the specific project. The request must identify the project of interest by public notice number and a self-addressed stamped envelope must also be provided for mailing the drawings to you. Your request for drawings should be addressed to the

**U.S. Army Corps of Engineers
ATTN: REGULATORY DIVISION
69A Hagood Avenue
Charleston, South Carolina 29403-5107**

The work shown on this application must be certified as consistent with applicable provisions of the Coastal Zone Management Program (15 CFR 930). The District Engineer will not process this application to a conclusion until such certification is received. ~~This activity may also require evaluation for compliance with the S.C. Construction in Navigable Waters Permit Program.~~ State review, permitting and certification is conducted by the S.C. Department of Health and Environmental Control. The applicant is hereby advised that supplemental information may be required by the State to facilitate the review. Persons wishing to comment or object to State certification or the navigable waters permit must submit all comments in writing to the S.C. Department of Health and Environmental Control at the above address within thirty (30) days of the date of this notice.

This notice initiates the Essential Fish Habitat (EFH) consultation requirements of the Magnuson-Stevens Fishery Conservation and Management Act. Implementation of the proposed project would impact estuarine substrates and emergent wetlands utilized by various life stages of species comprising the red drum, shrimp, and snapper-grouper management complexes. Our initial determination is that the proposed and existing action would not have a substantial individual or cumulative adverse impact on EFH or fisheries managed by the South Atlantic Fishery Management Council and the National Marine Fisheries Service (NMFS). Our final determination relative to project impacts and the need for mitigation measures is subject to review by and coordination with the NMFS.

The District Engineer has consulted the most recently available information and has determined that the project will have no effect on any Federally endangered, threatened, or proposed species and will not result in the destruction or adverse modification of designated or proposed critical habitat. This public notice serves as a request to the U.S. Fish and Wildlife Service and the National Marine Fisheries Service for any additional information they may have on whether any listed or proposed endangered or threatened species or designated or proposed critical habitat may be present in the area which would be affected by the activity, pursuant to Section 7(c) of the Endangered Species Act of 1973 (as amended).

The District Engineer has consulted the latest published version of the National Register of Historic Places for the presence or absence of registered properties, or properties listed as being eligible for inclusion therein, and this worksite is not included as a registered property or property listed as being eligible for inclusion in the Register. Consultation of the National Register constitutes the extent of cultural resource investigations by the District Engineer, and he is otherwise unaware of the presence of such resources. Presently unknown archaeological, scientific, prehistorical, or historical data may be lost or destroyed by the work to be accomplished under the requested permit.

Any person may request, in writing, within the comment period specified in this notice, that a public hearing be held to consider this application. Requests for a public hearing shall state, with particularity, the reasons for holding a public hearing.

REGULATORY DIVISION


Refer to: P/N #2002-1L-298-C
Robert P. Hucks


7 February 2003

The decision whether to issue a permit will be based on an evaluation of the probable impact including cumulative impacts of the activity on the public interest. That decision will reflect the national concern for both protection and utilization of important resources. The benefit which reasonably may be expected to accrue from the project must be balanced against its reasonably foreseeable detriments. All factors which may be relevant to the project will be considered including the cumulative effects thereof; among those are conservation, economics, aesthetics, general environmental concerns, wetlands, historic properties, fish and wildlife values, flood hazards, flood plain values, land use, navigation, shoreline erosion and accretion, recreation, water supply and conservation, water quality, energy needs, safety, food and fiber production and, in general, the needs and welfare of the people. A permit will be granted unless the District Engineer determines that it would be contrary to the public interest. In cases of conflicting property rights, the Corps of Engineers cannot undertake to adjudicate rival claims.

The Corps of Engineers is soliciting comments from the public; Federal, state, and local agencies and officials; Indian Tribes; and other interested parties in order to consider and evaluate the impacts of this activity. Any comments received will be considered by the Corps of Engineers to determine whether to issue, modify, condition or deny a permit for this project. To make this decision, comments are used to assess impacts on endangered species, historic properties, water quality, general environmental effects, and the other public interest factors listed above. Comments are used in the preparation of an Environmental Assessment and/or an Environmental Impact Statement pursuant to the National Environmental Policy Act. Comments are also used to determine the need for a public hearing and to determine the overall public interest of the activity.

If there are any questions concerning this public notice, please contact me at 843-329-8044 or toll free at 1-866-329-8187.

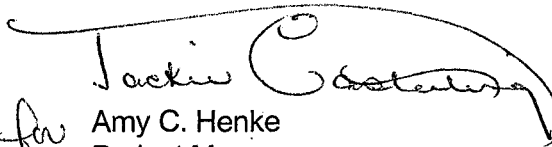

for Amy C. Henke
Project Manager
Regulatory Division
U.S. Army Corps of Engineers

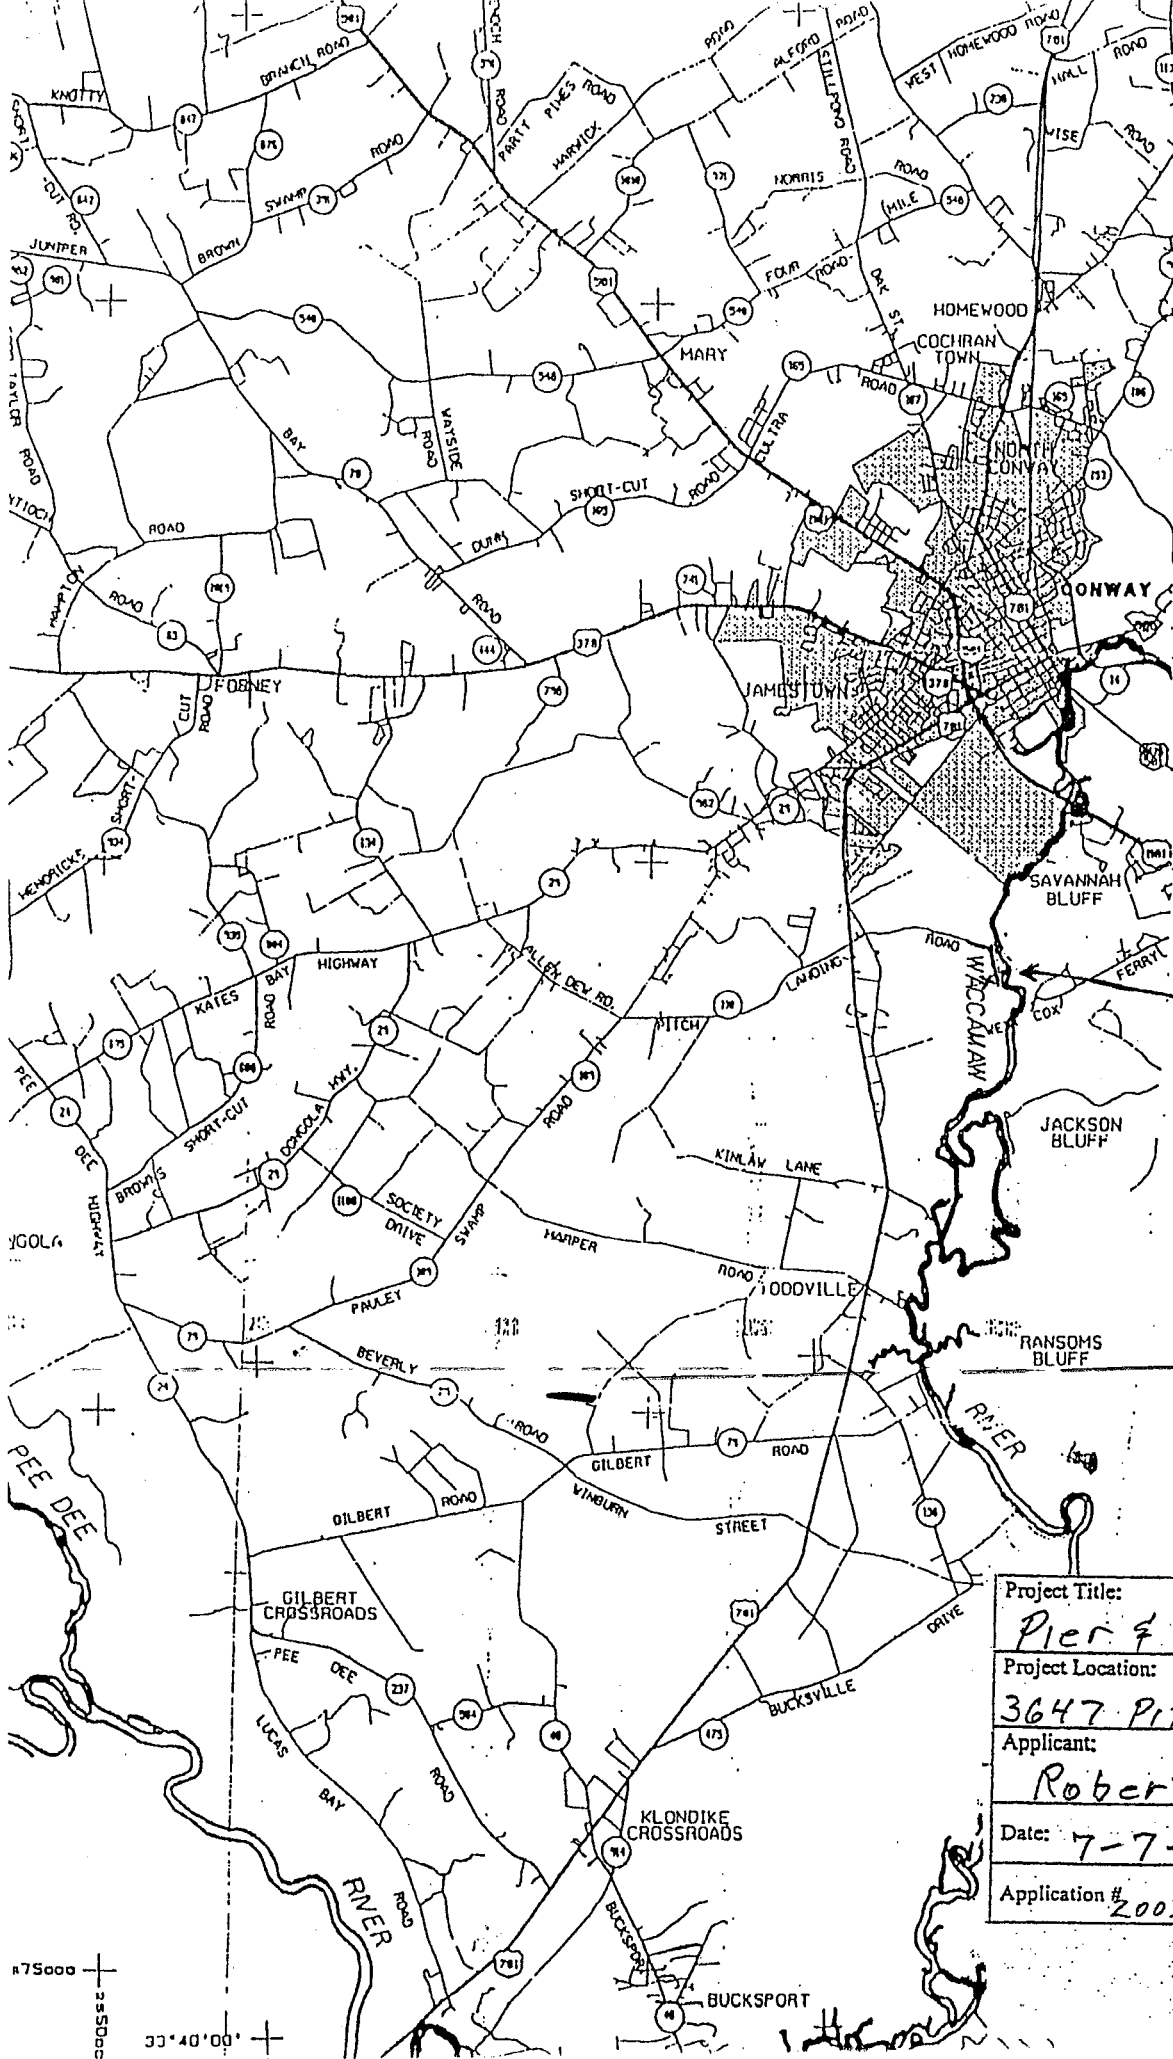

Project Site

Project Title: <i>Pier & Floating Dock</i>	
Project Location: <i>3647 Pitch Landing Drive</i>	
Applicant: <i>Robert P. Hucks</i>	
Date: <i>7-7-02</i>	Scale:
Application # <i>2002-12-298</i>	Sheet <i>1</i> of <i>4</i>

75000
33°40'00"

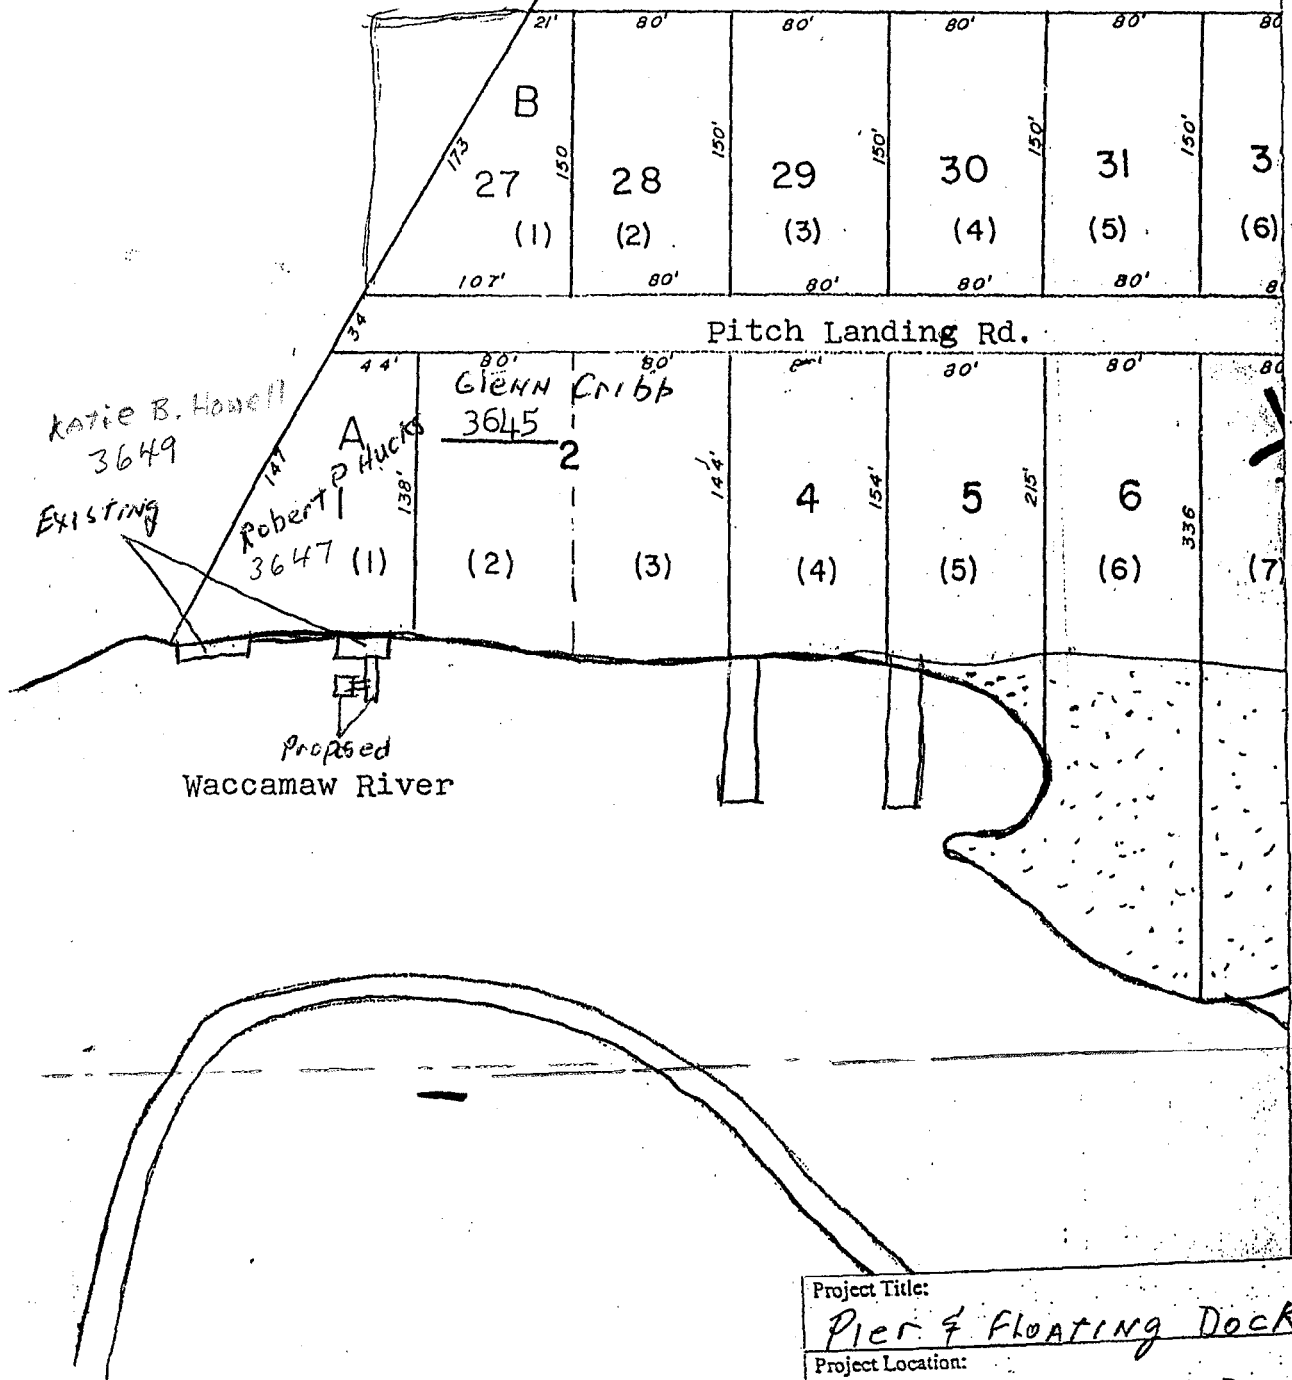


Project Title:	
Pier & Floating Dock	
Project Location:	
3647 Pitch Landing Drive	
Applicant:	
Robert P. Hucks	
Date:	Scale:
7-7-02	
Application #	Sheet
2002-IL-298	2 of 4

← North

WACCAMAW RIVER

Flow
Ebb

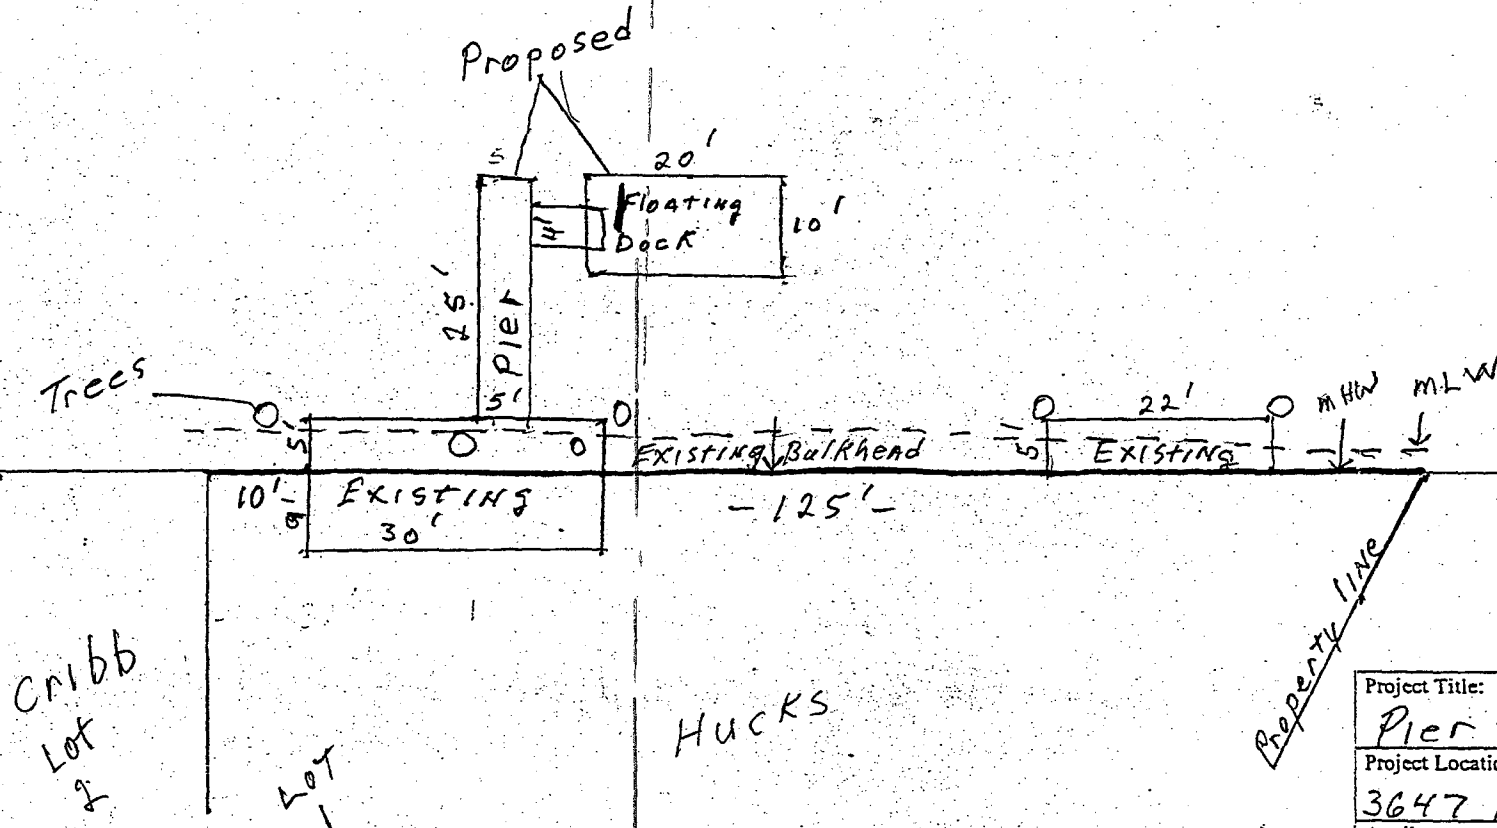

Project Title:

Pier & Floating Dock

Project Location:

3647 Pitch Landing Drive

Applicant:

Robert P. Hucks


Date: 7-7-02

Scale: 1" = 20'

Application # 2002-1L-298

Sheet 3 of 4

Revisions
Date: Initials

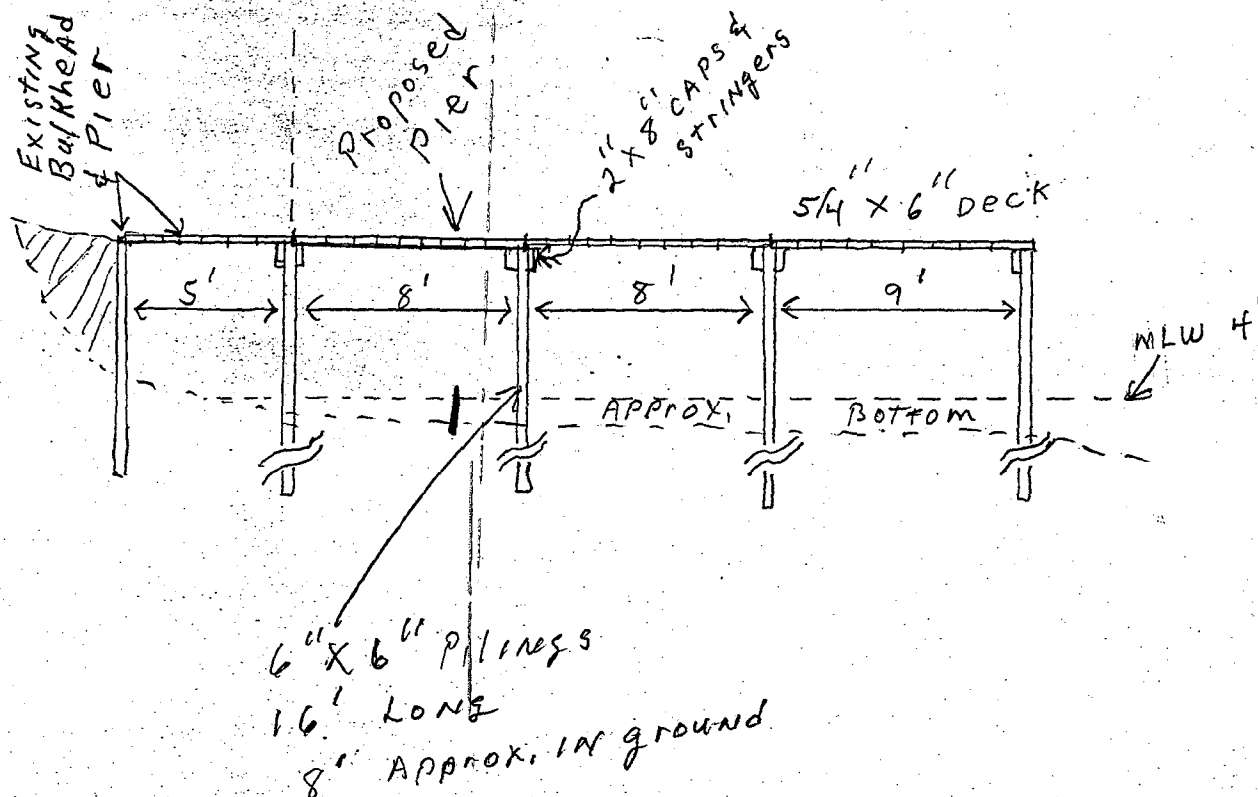

Project Title:		Pier & Floating Dock	
Project Location:		3647 Pitch Landing Drive	
Applicant:		Robert P. Hacks	
Date:	8-20-02	Scale:	1" = 6'
Application #		2002-1L-298 Sheet 4 of 4	

Revisions	
Date	Initials